




XREF: K:\PEPL\ORA\UPPRAG\32209\7_Uppdragsdokumentation\A\Lokaler\dwg\lyresgastforteckning.dwg ... \Planer\dwg\A40-P102.dwg ... \Planer\dwg\A40-P103.dwg ... \Planer\dwg\A40-P104.dwg ... \Planer\dwg\A40-P105.dwg ... \Planer\dwg\A40-P106.dwg ... \Planer\dwg\A40-P107.dwg ... \Planer\dwg\A40-P108.dwg

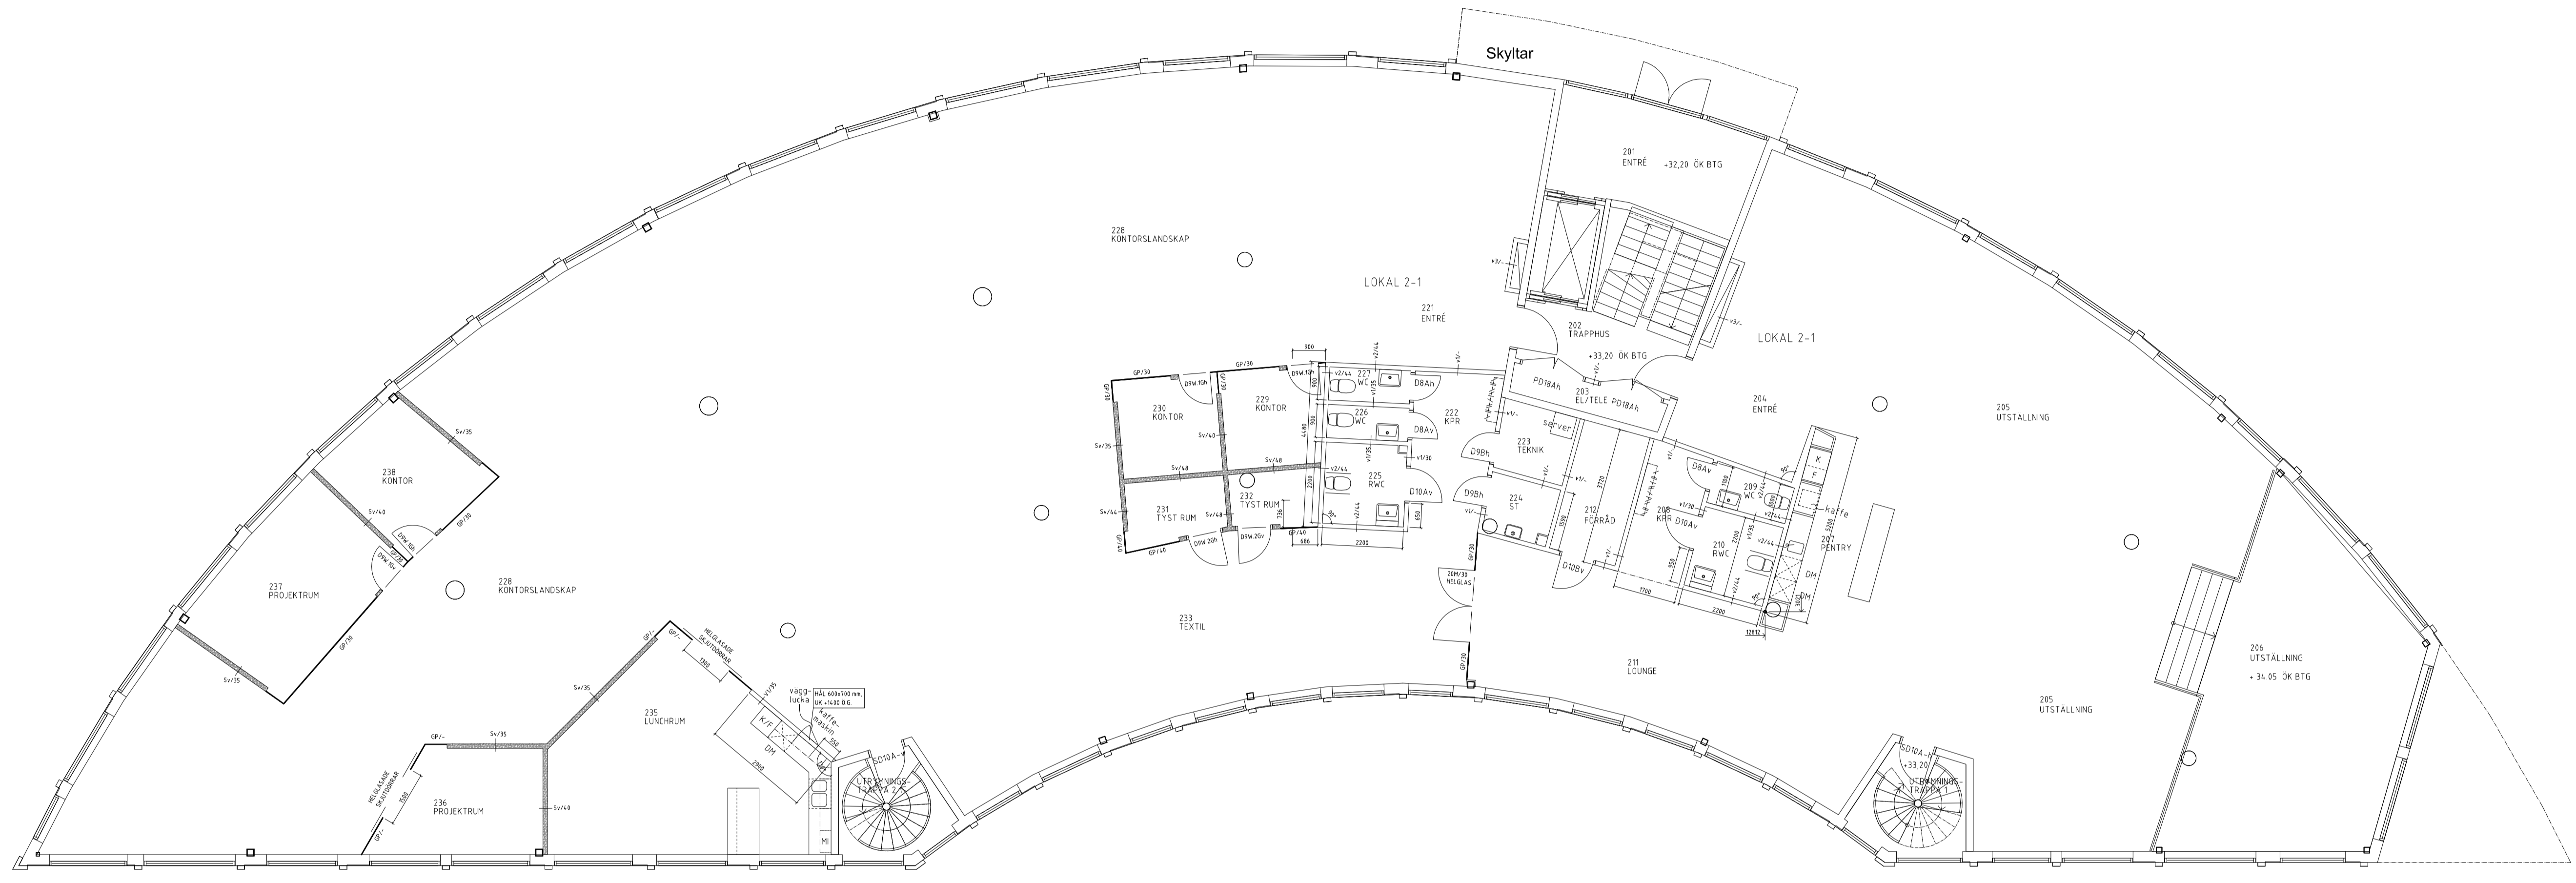

PLAN 2

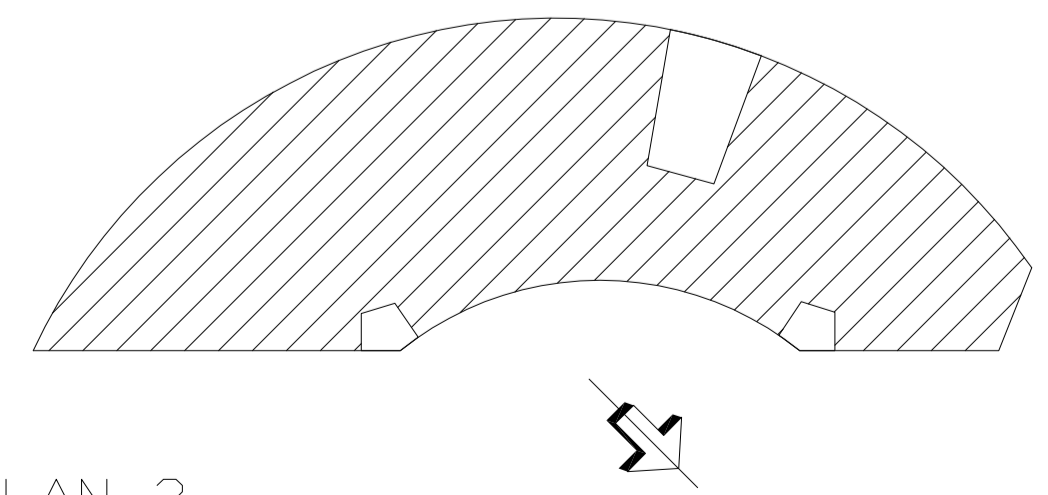

PLAN 2

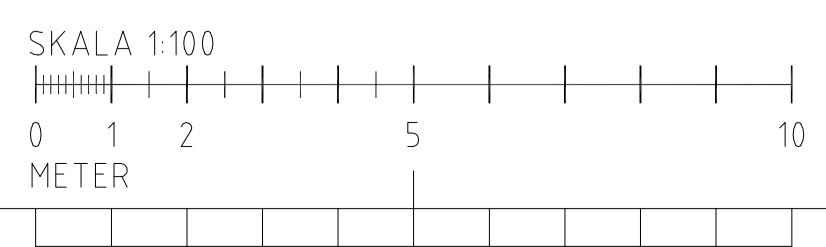

BET	ANT	ÄNDRINGEN AVSER	SIGN	DATUM
RELATIONSHANDLING				
TÅGMÄSTAREN 27, ÖREBRO				
 CASTELLUM TEL: 019 - 27 65 00				
 PE Teknik & Arkitektur PROJEKTENGEMANG				
UPPRAG NR 432209		RITAD AV EH		HANDLAGGARE M WIJK
DATUM 2017-09-18		ANSVARIG		
KONTORSHUS LOKAL 1, PLAN 2				
SKALA A1: 1:100 A3: 1:200	NUMMER L1		I BET	